

Vertical mounting styles with extra creepage distance


Surge Arrester IEEE Ratings V_r / V_{MCOV} (kV)	Style Number	Creepage Distance inches (mm)	Strike Distance inches (mm)	BIL 1.2/50 μ s dry kV _{peak}	Weight (Mass) lbs (kg)	A max inches (mm)	Fig
3.0 / 2.65	Q003SB002A	23.6 (599)	11.6 (297)	175	22 (10)	18.36 (466)	1
4.0 / 3.40	Q004SB003A	23.6 (599)	11.6 (297)	175	22 (10)	18.36 (466)	1
5.0 / 4.25	Q005SB004A	23.6 (599)	11.6 (297)	175	22 (10)	18.36 (466)	1
6.0 / 5.10	Q006SB005A	23.6 (599)	11.6 (297)	175	22 (10)	18.36 (466)	1
7.0 / 5.95	Q007SB006A	23.6 (599)	11.6 (297)	175	22 (10)	18.36 (466)	1
8.0 / 6.80	Q008SB007A	23.6 (599)	11.6 (297)	175	22 (10)	18.36 (466)	1
9.0 / 7.65	Q009SB008B	23.6 (599)	11.6 (297)	175	22 (10)	18.36 (466)	1
10 / 8.40	Q010SB009B	23.6 (599)	11.6 (297)	175	22 (10)	18.36 (466)	1
12 / 10.2	Q012SB010A	42 (1067)	17.6 (447)	250	33 (15)	24.27 (616)	1
15 / 12.7	Q015SB012A	42 (1067)	17.6 (447)	250	33 (15)	24.27 (616)	1
18 / 15.3	Q018SB015A	42 (1067)	17.6 (447)	250	33 (15)	24.27 (616)	1
21 / 17.0	Q021SB017B	42 (1067)	17.6 (447)	250	33 (15)	24.27 (616)	1
24 / 19.5	Q024SB019A	66.7 (1694)	25.5 (647)	350	47 (22)	32.14 (816)	1
27 / 22.0	Q027SB022A	66.7 (1694)	25.5 (647)	350	47 (22)	32.14 (816)	1
30 / 24.4	Q030SB024A	66.7 (1694)	25.5 (647)	350	47 (22)	32.14 (816)	1
33 / 27.0	Q033SB027A	66.7 (1694)	25.5 (647)	350	47 (22)	32.14 (816)	1
36 / 29.0	Q036SB029A	66.7 (1694)	25.5 (647)	350	47 (22)	32.14 (816)	1
39 / 31.5	Q039SB031B	66.7 (1694)	25.5 (647)	350	47 (22)	32.14 (816)	1
42 / 34.0	Q042SB034B	66.7 (1694)	25.5 (647)	350	47 (22)	32.14 (816)	1
45 / 36.5	Q045SB037A	84 (2134)	35.7 (907)	500	62 (29)	42.38 (1076)	2
48 / 39.0	Q048SB039A	84 (2134)	35.7 (907)	500	62 (29)	42.38 (1076)	2
51 / 41.0	Q051SB041A	84 (2134)	35.7 (907)	500	62 (29)	42.38 (1076)	2
54 / 42.0	Q054SB042A	84 (2134)	35.7 (907)	500	62 (29)	42.38 (1076)	2
55 / 44.0	Q055SB044A	84 (2134)	35.7 (907)	500	62 (29)	42.38 (1076)	2
60 / 48.0	Q060SB048A	84 (2134)	35.7 (907)	500	62 (29)	42.38 (1076)	2
66 / 53.0	Q066SB053A	84 (2134)	35.7 (907)	500	62 (29)	42.38 (1076)	2
72 / 57.0	Q072SB057A	106.7 (2761)	43.6 (1107)	600	76 (35)	50.25 (1276)	2
75 / 60.0	Q075SB060A	106.7 (2761)	43.6 (1107)	600	76 (35)	50.25 (1276)	2
78 / 63.0	Q078SB063A	106.7 (2761)	43.6 (1107)	600	76 (35)	50.25 (1276)	2
81 / 65.0	Q081SB065A	106.7 (2761)	43.6 (1107)	600	76 (35)	50.25 (1276)	2
84 / 68.0	Q084SB068A	106.7 (2761)	43.6 (1107)	600	76 (35)	50.25 (1276)	2
90 / 70.0	Q090SB070A	133.4 (3388)	51.5 (1307)	700	90 (41)	58.12 (1476)	2
94 / 73.0	Q094SB073A	133.4 (3388)	51.5 (1307)	700	90 (41)	58.12 (1476)	2
96 / 76.0	Q096SB076B	133.4 (3388)	51.5 (1307)	700	90 (41)	58.12 (1476)	2
102 / 82.0	Q102SB082B	133.4 (3388)	51.5 (1307)	700	90 (41)	58.12 (1476)	2
106 / 84.0	Q106SB084D	133.4 (3388)	51.5 (1307)	700	90 (41)	58.12 (1476)	2
106 / 86.0	Q106SB086B	133.4 (3388)	51.5 (1307)	700	90 (41)	58.12 (1476)	2
114 / 92.0	Q114SB092B	150.7 (3828)	50.0 (1269)	850	109 (50)	68.86 (1749)	4
120 / 98.0	Q120SB098D	150.7 (3828)	50.0 (1269)	850	109 (50)	68.86 (1749)	4
129 / 104	Q129SB104B	150.7 (3828)	50.0 (1269)	850	109 (50)	68.86 (1749)	4
132 / 106	Q132SB106D	150.7 (3828)	50.0 (1269)	850	109 (50)	68.86 (1749)	4
138 / 111	Q138SB111B	175.4 (4455)	57.8 (1469)	950	123 (56)	76.73 (1949)	4
144 / 115	Q144SB115C	175.4 (4455)	57.8 (1469)	950	123 (56)	76.73 (1949)	4
150 / 121	Q150SB121B	175.4 (4455)	57.8 (1469)	950	123 (56)	76.73 (1949)	4
168 / 131	Q168SB131C	200.1 (5082)	65.7 (1669)	1050	137 (63)	84.61 (2149)	4
172 / 140	Q172SB140C	200.1 (5082)	65.7 (1669)	1050	137 (63)	84.61 (2149)	4

Vertical mounting styles with extra extra creepage distance


Surge Arrester IEEE Ratings V_r / V_{MCOV} (kV)	Style Number	Creepage Distance inches (mm)	Strike Distance inches (mm)	BIL 1.2/50 μ s dry kV _{peak}	Weight (Mass) lbs (kg)	A max inches (mm)	Fig
3.0 / 2.55	Q003SC002A	42 (1067)	17.6 (447)	250	33 (15)	24.27 (616)	1
4.0 / 3.40	Q004SC003A	42 (1067)	17.6 (447)	250	33 (15)	24.27 (616)	1
5.0 / 4.25	Q005SC004A	42 (1067)	17.6 (447)	250	33 (15)	24.27 (616)	1
6.0 / 5.10	Q006SC005A	42 (1067)	17.6 (447)	250	33 (15)	24.27 (616)	1
7.0 / 5.95	Q007SC006A	42 (1067)	17.6 (447)	250	33 (15)	24.27 (616)	1
8.0 / 6.80	Q008SC007A	42 (1067)	17.6 (447)	250	33 (15)	24.27 (616)	1
9.0 / 7.65	Q009SC008B	42 (1067)	17.6 (447)	250	33 (15)	24.27 (616)	1
10 / 8.40	Q010SC008B	42 (1067)	17.6 (447)	250	33 (15)	24.27 (616)	1
12 / 10.2	Q012SC010A	66.7 (1694)	25.5 (647)	350	47 (22)	32.14 (816)	1
15 / 12.7	Q015SC012A	66.7 (1694)	25.5 (647)	350	47 (22)	32.14 (816)	1
18 / 15.3	Q018SC015A	66.7 (1694)	25.5 (647)	350	47 (22)	32.14 (816)	1
21 / 17.0	Q021SC017B	66.7 (1694)	25.5 (647)	350	47 (22)	32.14 (816)	1
24 / 19.5	Q024SC019A	84 (2134)	35.7 (907)	500	62 (29)	42.38 (1076)	2
27 / 22.0	Q027SC022A	84 (2134)	35.7 (907)	500	62 (29)	42.38 (1076)	2
30 / 24.4	Q030SC024A	84 (2134)	35.7 (907)	500	62 (29)	42.38 (1076)	2
33 / 27.0	Q033SC027A	84 (2134)	35.7 (907)	500	62 (29)	42.38 (1076)	2
36 / 29.0	Q036SC029A	84 (2134)	35.7 (907)	500	62 (29)	42.38 (1076)	2
39 / 31.5	Q039SC031B	84 (2134)	35.7 (907)	500	62 (29)	42.38 (1076)	2
42 / 34.0	Q042SC034B	84 (2134)	35.7 (907)	500	62 (29)	42.38 (1076)	2
45 / 36.5	Q045SC037A	108.7 (2761)	43.6 (1107)	600	76 (35)	50.25 (1276)	2
48 / 39.0	Q048SC039A	108.7 (2761)	43.6 (1107)	600	76 (35)	50.25 (1276)	2
51 / 41.0	Q051SC041A	108.7 (2761)	43.6 (1107)	600	76 (35)	50.25 (1276)	2
54 / 42.0	Q054SC042A	108.7 (2761)	43.6 (1107)	600	76 (35)	50.25 (1276)	2
55 / 44.0	Q055SC044A	108.7 (2761)	43.6 (1107)	600	76 (35)	50.25 (1276)	2
60 / 48.0	Q060SC048A	108.7 (2761)	43.6 (1107)	600	76 (35)	50.25 (1276)	2
66 / 53.0	Q066SC053A	108.7 (2761)	43.6 (1107)	600	76 (35)	50.25 (1276)	2
72 / 57.0	Q072SC057A	133.4 (3398)	51.5 (1307)	700	90 (41)	58.12 (1476)	2
75 / 60.0	Q075SC060A	133.4 (3398)	51.5 (1307)	700	90 (41)	58.12 (1476)	2
78 / 63.0	Q078SC063A	133.4 (3398)	51.5 (1307)	700	90 (41)	58.12 (1476)	2
81 / 65.0	Q081SC065A	133.4 (3398)	51.5 (1307)	700	90 (41)	58.12 (1476)	2
84 / 68.0	Q084SC068A	133.4 (3398)	51.5 (1307)	700	90 (41)	58.12 (1476)	2
90 / 70.0	Q090SC070A	150.7 (3828)	50.0 (1269)	850	109 (50)	68.86 (1749)	4
94 / 73.0	Q094SC073A	150.7 (3828)	50.0 (1269)	850	109 (50)	68.86 (1749)	4
96 / 76.0	Q096SC076B	150.7 (3828)	50.0 (1269)	850	109 (50)	68.86 (1749)	4
102 / 82.0	Q102SC082B	150.7 (3828)	50.0 (1269)	850	109 (50)	68.86 (1749)	4
108 / 84.0	Q108SC084D	150.7 (3828)	50.0 (1269)	850	109 (50)	68.86 (1749)	4
108 / 88.0	Q108SC088B	150.7 (3828)	50.0 (1269)	850	109 (50)	68.86 (1749)	4
114 / 92.0	Q114SC092B	175.4 (4455)	57.8 (1469)	950	123 (56)	76.73 (1949)	4
120 / 98.0	Q120SC098D	175.4 (4455)	57.8 (1469)	950	123 (56)	76.73 (1949)	4
129 / 104	Q129SC104B	175.4 (4455)	57.8 (1469)	950	123 (56)	76.73 (1949)	4
132 / 106	Q132SC106D	175.4 (4455)	57.8 (1469)	950	123 (56)	76.73 (1949)	4
138 / 111	Q138SC111B	200.1 (5092)	65.7 (1669)	1050	137 (63)	86.41 (2149)	4
144 / 115	Q144SC115C	200.1 (5092)	65.7 (1669)	1050	137 (63)	86.41 (2149)	4
150 / 121	Q150SC121B	200.1 (5092)	65.7 (1669)	1050	137 (63)	86.41 (2149)	4

Figures


1 Single housing

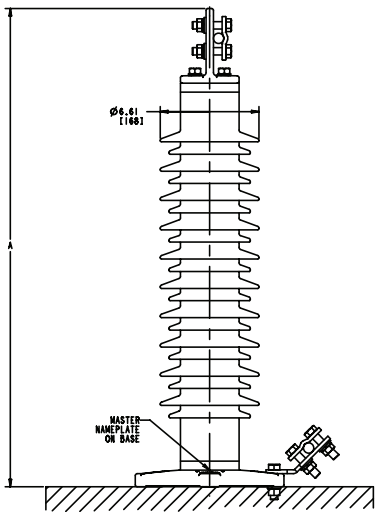


2 Double housing

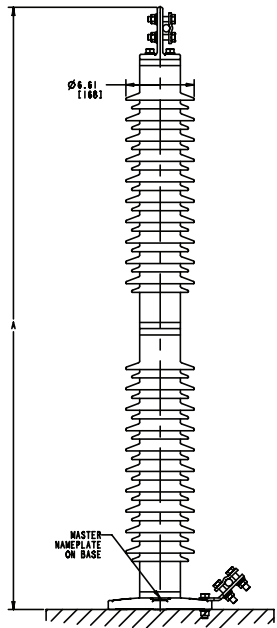

4 Triple housing with ring

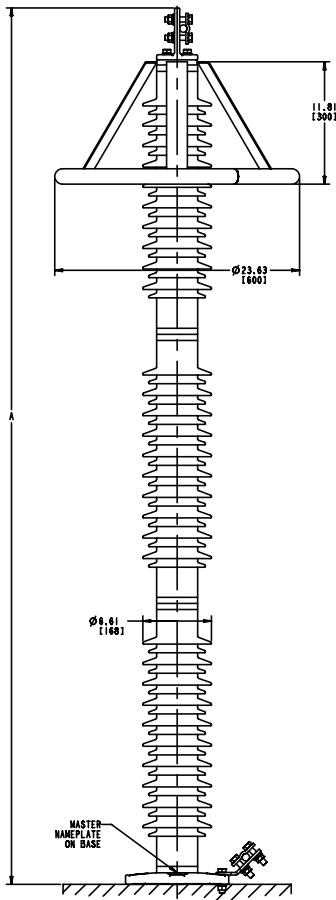

3 Double housing with ring

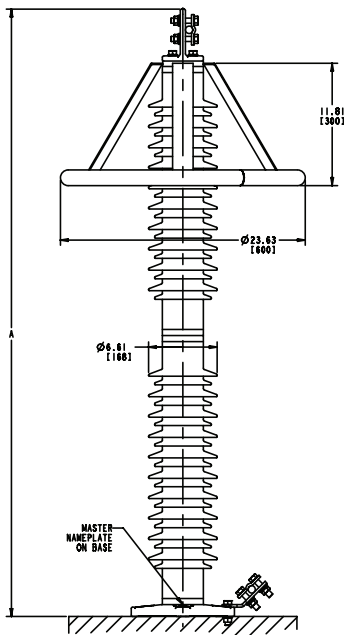


Optional mountings

Under-hung mounted styles

Available for all ratings. To select, add 'UH' to the end of the style number.

(Example: 5 kV Q015SA012AUH)

Single housing under-hung

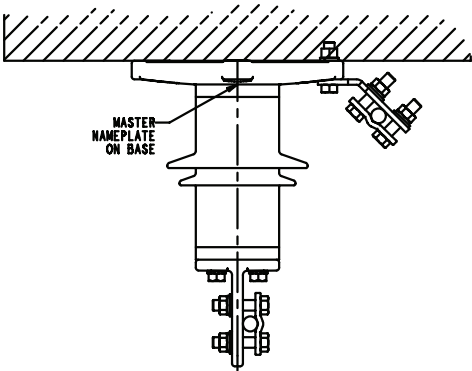

Cubical mounted styles

Available for rating 3 to 66 kV. To select, add 'SAA6' to the end of the style number.

(Example: 15 kV Q015SA012ASAA6)

Single housing cubical

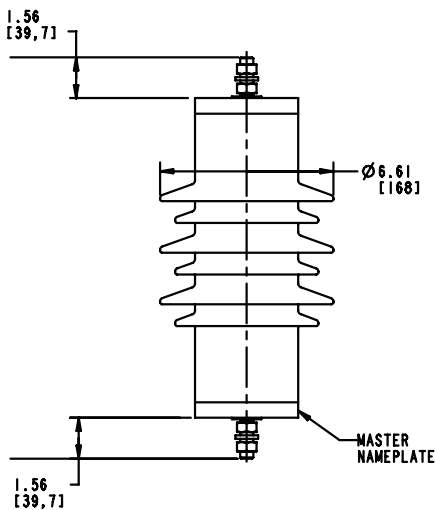




ABB		DATE		POLIM-S		U.S.A.			
STYLE NO.				SERIAL NO.					
WEIGHT		MCOV		kV		RATING		kV	

Nameplate for cubical mounted styles only.

Standard hardware



Line terminal

Aluminum / galvanized steel

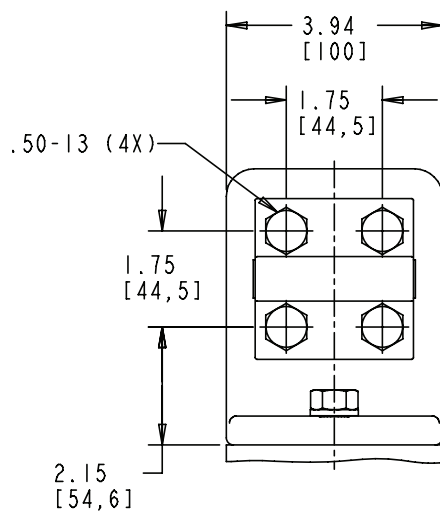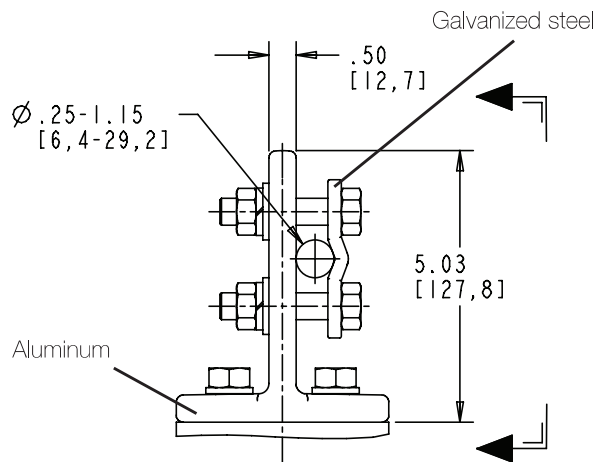

Ground terminal

Galvanized steel

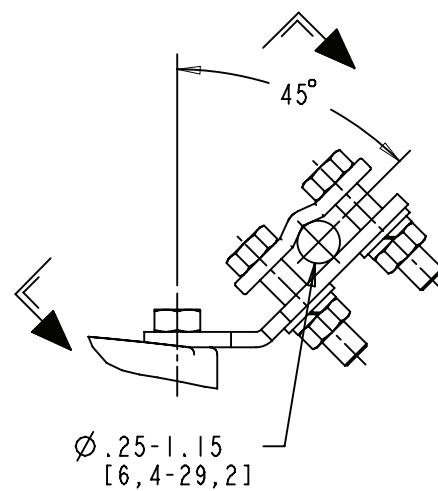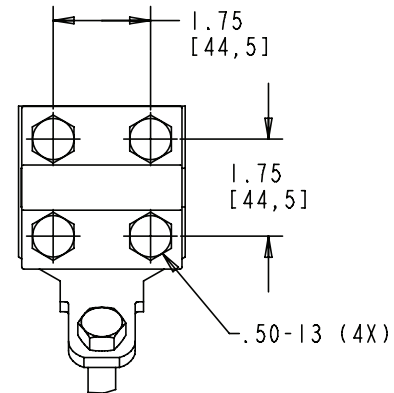

Note: Line and ground terminals can accommodate copper or aluminum cable size Number 2 to 1000 MCM / 0.25 to 1.15 in. diameter. Ground terminal can be located on any lug.

Phase-to-ground clearance

The phase-to-ground clearance in substations is usually based on the selected standard rated lightning and switching impulse withstand voltages. International standards, e.g. IEC 60071-2, recommend minimum clearances.

In general, the clearance between a grounded object and a surge arrester should be the same as the phase-to-ground clearance selected for other high voltage equipment in a substation. If it is not possible to use the normal phase-to-ground clearance in special applications of POLIM-S Surge Arresters, a smaller clearance may be chosen, considering the protective characteristics of the arrester. At system voltages 24 kV and below, the margin between the rated withstand voltage of the substation and the protective level of the surge arrester is large. Furthermore, distance effects by fast transients do not exist in the immediate vicinity of the surge arrester.

Thus, the recommended minimum phase-to-ground clearance for POLIM-S Surge Arresters, with regard to lightning and switching overvoltages are presented in Figure 1. These clearances are based on IEC 60071-2, Table VI, and on the protective characteristics of the surge arrester. They include safety margins and altitude correction.

The *Adjusted Protective Level* to be used in Figure 1, is defined as:

- For lightning impulse:

$$L_{pl} \times 1.15 \times e^{H/8150}$$


- For switching impulse:

$$S_{pl} \times 1.10 \times e^{H/8150}$$

H is the altitude in meters above sea level.

L_{pl} and S_{pl} are the lightning and switching impulse protective levels for the selected POLIM-S Surge Arresters at the respective coordinating currents.

The minimum clearance is determined either by lightning or switching impulse withstand, whichever renders a larger value.

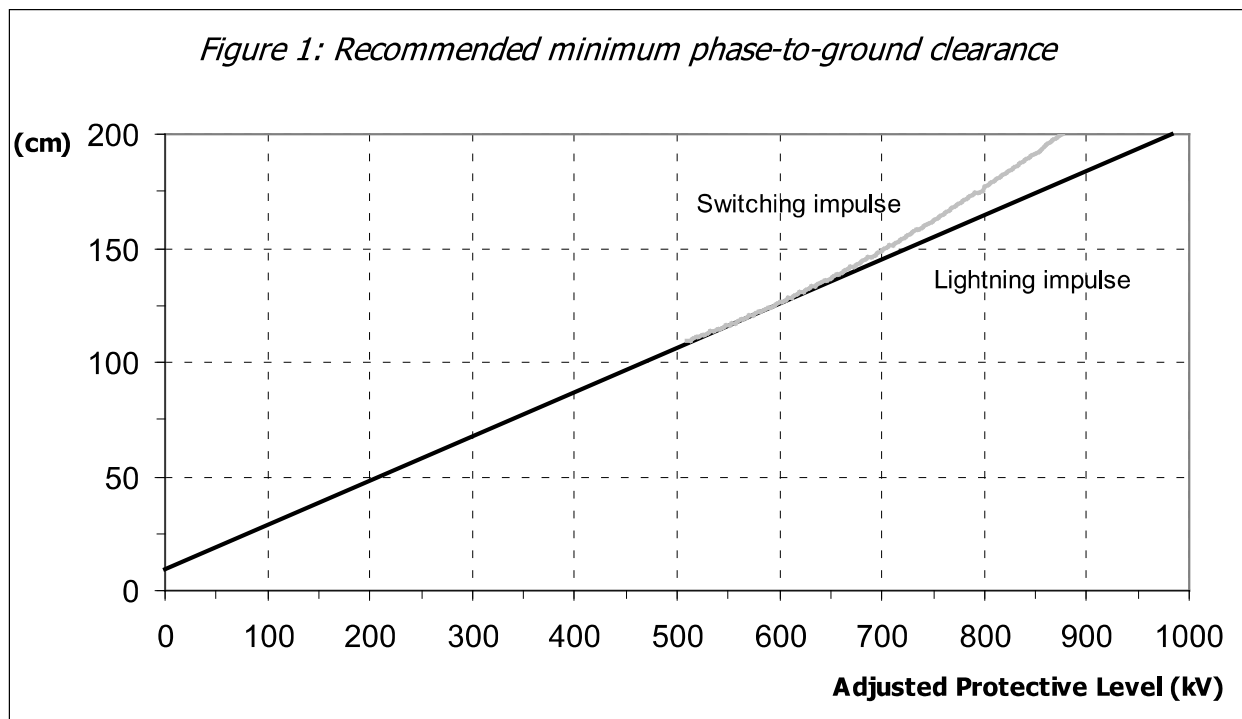

Phase-to-phase clearance

The phase-to-phase clearance for high voltage equipment in a substation is normally based on the selected standard rated lightning and switching impulse phase-to-phase withstand voltages. International standards, e.g. IEC 60071-3 recommend minimum phase-to-phase clearances. Note that the normal election of surge arrester protective levels does not directly protect the phase-to-phase insulation.

In general, the clearance between surge arresters in adjacent phases should be the same as the phase-to-phase clearance selected for other high voltage equipment in the substation. If it is not possible to use the normal phase-to-phase clearance in a special application of POLIM-S Surge Arresters, the minimum clearance with regard to lightning overvoltages can be derived from Figure 2.


The clearances shown in Figure 2 are based on the assumption that one phase is subjected to a lightning overvoltage, while the voltage on the adjacent phase is at the peak of the maximum power frequency operating voltage (opposite polarity). Obviously, these clearances will also cover the case of lightning overvoltages of the same polarity appearing simultaneously on two or three phases.

The *Adjusted Protective Level* shown in Figure 2 is based on the lightning protective characteristics of the selected POLIM-S Surge Arresters. It includes safety margin and altitude correction factors and is defined as:

$$L_{pl} \times 1.15 \times e^{H/8150} + V_m \times \sqrt{2} / \sqrt{3}$$

- V_m is the highest voltage for equipment according to IEC 60071-1, which is usually equal to the highest system voltage.
- L_{pl} is the lightning impulse protective level for the selected POLIM-S Surge Arrester.

The minimum phase-to-phase clearance for arresters with respect to switching overvoltages should always be based on the selected standard rated switching impulse phase-to-phase withstand voltage for the substation. Consequently, the clearances specified in IEC 60071-3, Table VI, are valid for most applications of arresters. If a special application requires a minimized phase spacing, the favorable electrode configuration established by the grading rings on POLIM-S Surge Arresters may permit a further reduction of the phase-to-phase clearance.

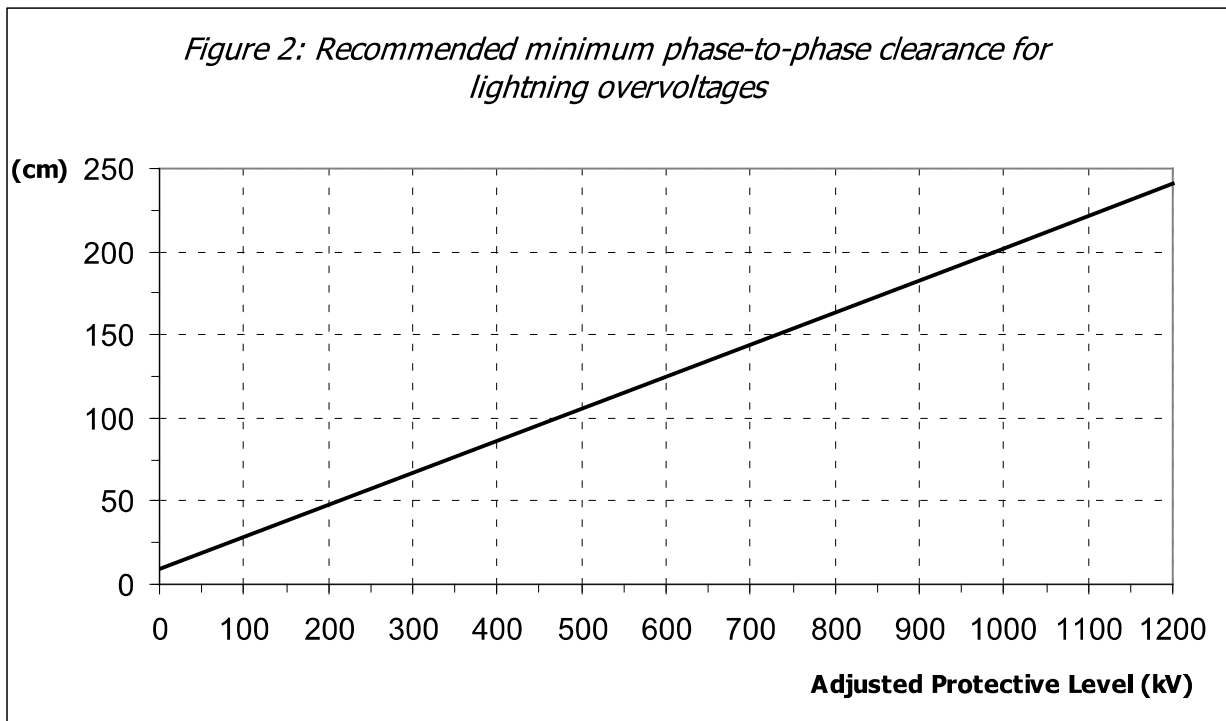

Contact us

ABB Inc.
High Voltage Products - Surge Arresters
100 Distribution Circle
Mount Pleasant, Pennsylvania 15666, USA
Phone: +1 (724) 696-1568
Fax: +1 (724) 696-1502
www.abb.us

*AS BUILT
DRAWINGS*

1	CHANGE
2	CORRECTED RETIERS R. CLARK 5/3/16
3	ADDED 40KV ARRESTERS R. CLARK 5/3/16
4	ADDED 40KV ARRESTERS R. CLARK 5/3/16
5	ADDED 40KV ARRESTERS R. CLARK 5/3/16
6	ADDED 40KV ARRESTERS R. CLARK 5/3/16
7	ADDED 40KV ARRESTERS R. CLARK 5/3/16

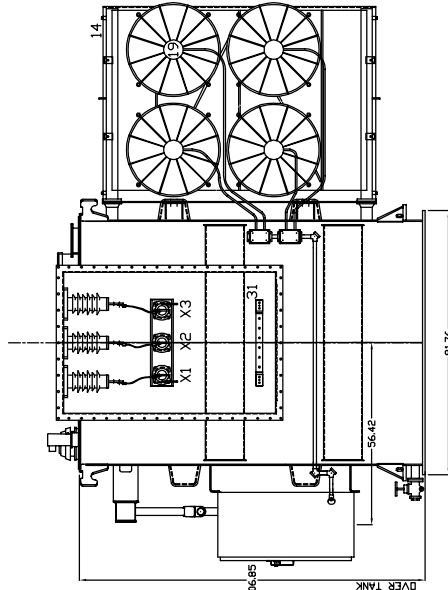
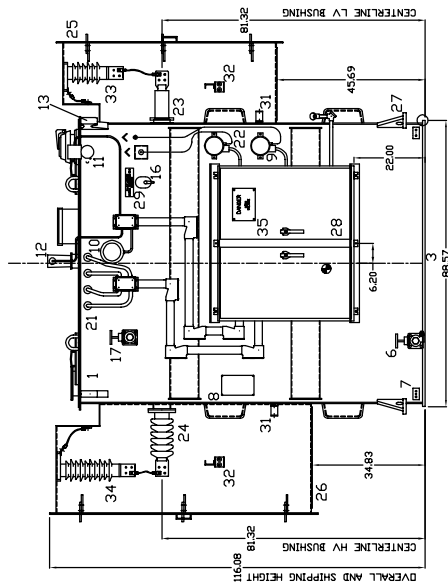
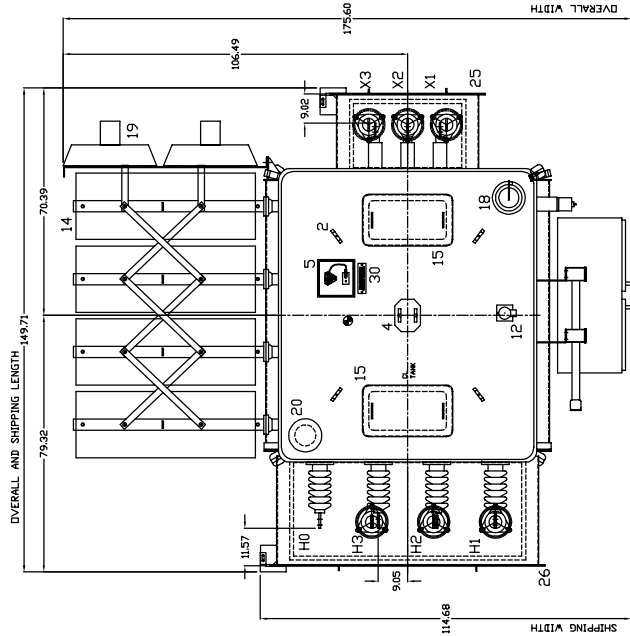


ABB INC. SMALL POWER TRANSFORMERS SOUTH BOSTON, VIRGINIA U.S.A.

APPROXIMATE NET WEIGHTS

CORE AND COILS ----- 31737 LBS.
TANK AND FITTINGS ----- 15455 LBS.
LIQUID - NATURAL ESTER FLUID - 2505 GAL. ----- 6937 LBS.
APPROXIMATE TRANSFORMER SHIPPING WEIGHT ----- 57884 LBS.
COOLER LIQUID TOTAL --- 238 GAL. ----- 1869 LBS.
MAXIMUM COOLER ASSEMBLY WEIGHT EACH ----- 1593 LBS.
(COOLER WEIGHTS ARE INCLUDED IN TANK AND FITTINGS WEIGHT)
(COOLER LIQUID WEIGHT IS INCLUDED IN LIQUID WEIGHT)

- ITEM
1. SEALED TANK - BRASER FOR 15 PSI - COLOR ANST 61
 2. SEALED COVER WITH GASKET AND LIFTING LOOPS FOR LIFTING COVER ONLY.
 3. BASE - DESIGNED FOR ROLLING PARALLEL TO CENTERLINES
 4. FALL ARREST MOUNTING BASE - FOR MANUFACTURING PURPOSES.
 5. REMOVABLE EXTERNAL CORE GROUND LOCATED INSIDE ENCLOSURE.
 6. STAINLESS STEEL GROUND PAIS - 2 HOLE NEMA BRILLING - 8 TOTAL.
 7. NAMEPLATE AND WARNING DECAL.
 8. LIQUID TEMPERATURE GAUGE WITH ALARM CONTACTS.
 9. MAGNETIC LIQUID LEVEL GAUGE WITH ALARM CONTACTS.
 10. VACUUM PRESSURE GAUGE WITH ALARM CONTACT AIR TEST (BLEEDER) AND SEALED AIRE.
 11. LIFTING HOOK FOR LIFTING COMPLETE TRANSFORMER.
 12. THE TRANSFORMER IS DESIGNED FOR LIFTING WITH 4 VERTICAL SLINGS. THIS MAY REQUIRE THE USE OF A SPREADER OR LIFTING BEAM.
 13. REMOVABLE 205" GALVANIZED RADIATORS - 4 TOTAL.
 14. FIELD FILLING INSTRUCTIONS - SEE DRAWING 8012328 - CASE 2 - A = 218
 15. BOLTED MANHOLE - 24.00 X 12.00 OPENING WITH NITRILE GASKET - 2 TOTAL.
 16. DE-ENERGIZED TAP CHANGER - WITH .38 HOLE FOR PADLOCKING.
 17. 2.0 VALVE FOR UPPER FILTER PRESS CONNECTION.
 18. RELIEF DEVICE WITH SEMAPHORE, OVER A 6.50 HANDHOLE.
 19. AIR BLAST FAN ENCLOSED IN SAFETY CAGE - .04 TOTAL.
 20. CURRENT TRANSFORMER FEED THROUGH - 4 TOTAL.
 21. REMOTE HOT SPOT WINDING TEMPERATURE INDICATOR WITH ALARMS.
 22. LV BUSHING STYLE 8012973001 10.00 CL TO CL - SEE DETAIL 23.
 23. HV BUSHING STYLE 8012424001 18.10 CL TO CL - SEE DETAIL 24.
 24. HV WELD-IN ATC WITH NON-MAGNETIC ENTRANCE PLATE - SEE DETAIL 02.
 25. HV WELD-IN ATC WITH NON-MAGNETIC ENTRANCE PLATE - PER DETAIL 03.
 26. JACKING PROVISIONS ON TANK FOR JACKING COMPLETE UNIT
 27. NEMA 4 CONTROL CABINET.
 28. TAP CHANGER WARNING TAG.
 29. TAP CHANGER WARNING TAG.
 30. COILER GROUNDING TAG.
 31. COILER GROUNDING TAG.
 32. CABLE SUPPORTS - 2 TOTAL.
 33. 18KV STATION CLASS ARRESTERS, ABB STYLE# 0018050181A - 3 TOTAL.
 34. 48KV STATION CLASS ARRESTERS, ABB STYLE# 0042501348 - 3 TOTAL.
 35. DANGER HIGH VOLTAGE SIGN.

ITEMS ARE REMOVED FOR SHIPMENT

RENEWAL PARTS FOR OUTLINE
1 OF EACH STYLE BUSHING IS RECOMMENDED FOR STOCK.
FOR PRICES CONTACT YOUR FIELD SALES OFFICE.
ORDER RENEWAL PARTS BY STYLE NUMBER AS FOLLOWS:
STYLE NUMBER = OUTLINE NUMBER - ITEM NUMBER - QUANTITY.
EXAMPLE: BS0013201-24-1
FOR GASKETS ONLY PLACE A 'G' IN FRONT OF OUTLINE NUMBER
EXAMPLE: GBS0013201-24-1 (ONE GASKET)
EXAMPLE: GBS0013201 (ALL GASKETS)



DESIGNATES CENTER OF GRAVITY COMPLETE	TEMP. RISE	DESIGNATES CENTER OF GRAVITY COMPLETE	TEMP. RISE
FROM GROUND IN FRONT VIEW	65° C	FROM GROUND IN FRONT VIEW	65° C
LEFT OF CENTERLINE TOP VIEW		LEFT OF CENTERLINE TOP VIEW	
DESIGN IMPEDANCE 0.500 %		DESIGN IMPEDANCE 0.500 %	
HV 150 KV BIL LV 90 KV BIL		HV 150 KV BIL LV 90 KV BIL	
APPARATUS UNIT SUBSTATION TRANSFORMER	CLASS	APPARATUS UNIT SUBSTATION TRANSFORMER	CLASS
60 HERTZ	LV 34500V/11992	60 HERTZ	LV 34500V/11992
DFM KCL-44	LV 34500V/11992	DFM KCL-44	LV 34500V/11992
CHD D-6111	LV 34500V/11992	CHD D-6111	LV 34500V/11992
APPO	PC-1002	APPO	PC-1002
SMALL POWER TRANSFORMER		SMALL POWER TRANSFORMER	
APPARATUS UNIT SUBSTATION TRANSFORMER	CLASS	APPARATUS UNIT SUBSTATION TRANSFORMER	CLASS
60 HERTZ	LV 34500V/11992	60 HERTZ	LV 34500V/11992
DFM KCL-44	LV 34500V/11992	DFM KCL-44	LV 34500V/11992
CHD D-6111	LV 34500V/11992	CHD D-6111	LV 34500V/11992
APPO	PC-1002	APPO	PC-1002
SMALL POWER TRANSFORMER		SMALL POWER TRANSFORMER	

AS BUILT DRAWINGS

Mar 21, 2016

ABB - South Boston, VA

CHANGE

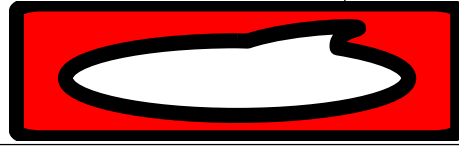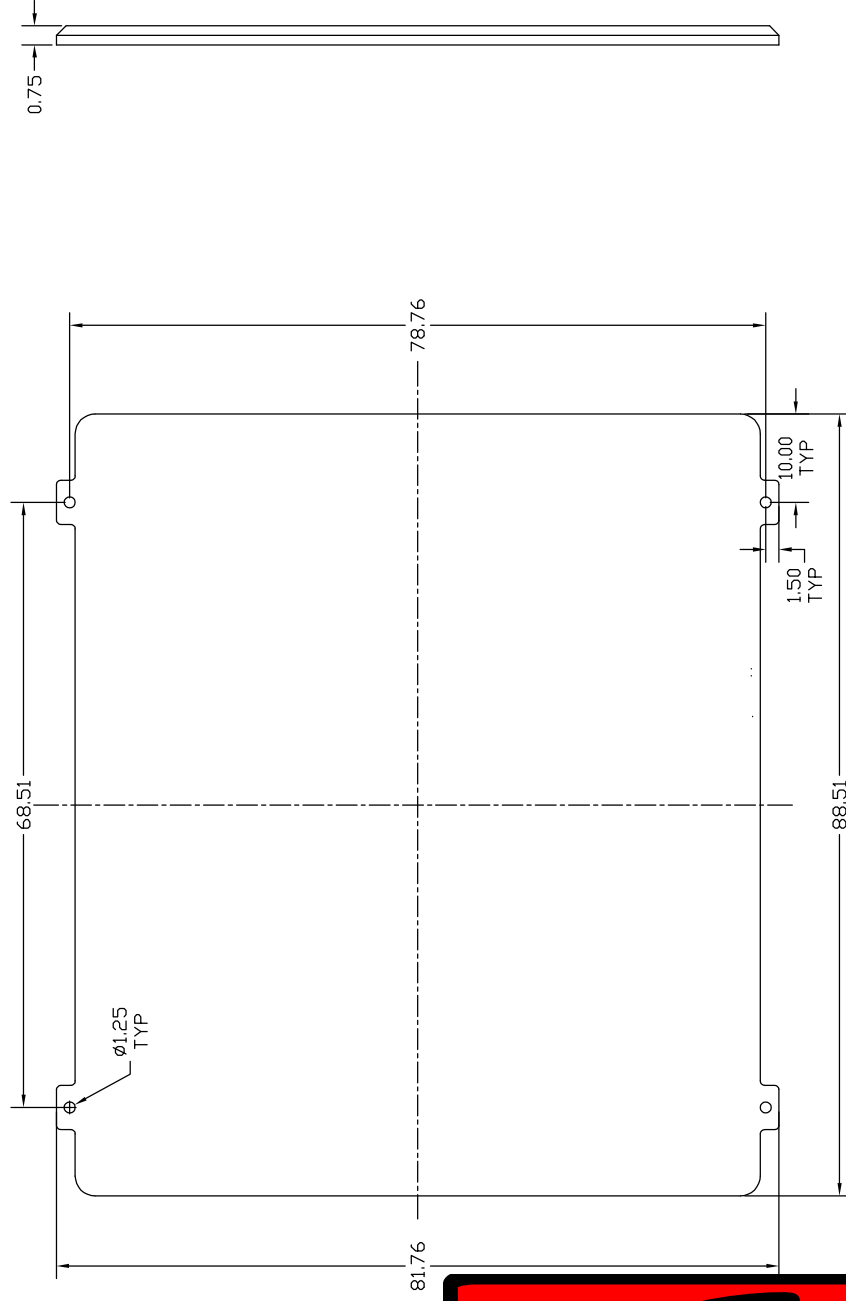

DETAIL NUMBER 01 - BASE
SHOP ORDER BS00132

AS BUILT DRAWINGS

Mar 21, 2016

ABB - South Boston, VA


ABB

ABB INC.
SOUTH BOSTON, VIRGINIA U.S.A.

DIMENSIONS IN INCHES - NTS



CHANGE

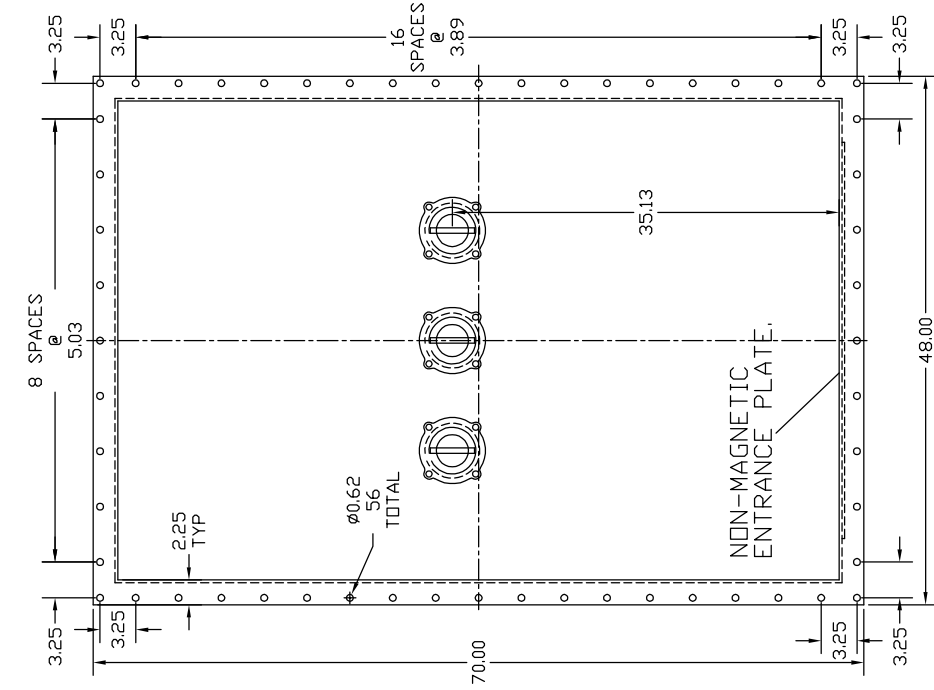

AS BUILT DRAWINGS
Mar 21, 2016
ABB - South Boston, VA

REMOVABLE FRONT
DETAIL NUMBER 02 - ACCESS PANEL
SHOP ORDER BS00132

THROAT HAS 19.82 X 33.50 HANDHOLE


ABB ABB INC.
SOUTH BOSTON, VIRGINIA U.S.A.

DIMENSIONS IN INCHES - NTS



CHANGE

AS BUILT DRAWINGS
Mar 21, 2016
ABB - South Boston, VA

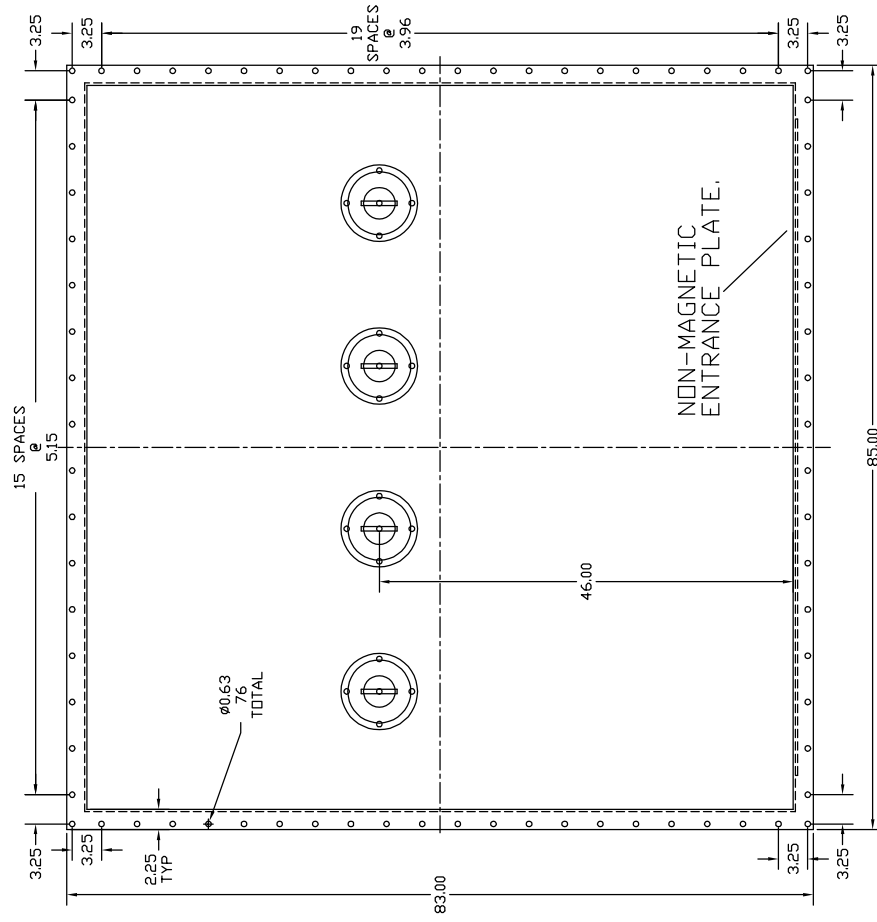

REMOVABLE FRONT
DETAIL NUMBER 03 - ACCESS PANEL
SHOP ORDER BS00132

THROAT HAS 28.82 X 70.50 HANDHOLE

ABB


ABB INC.
SOUTH BOSTON, VIRGINIA U.S.A.

DIMENSIONS IN INCHES - NTS

CHANGE

AIR END

OIL END

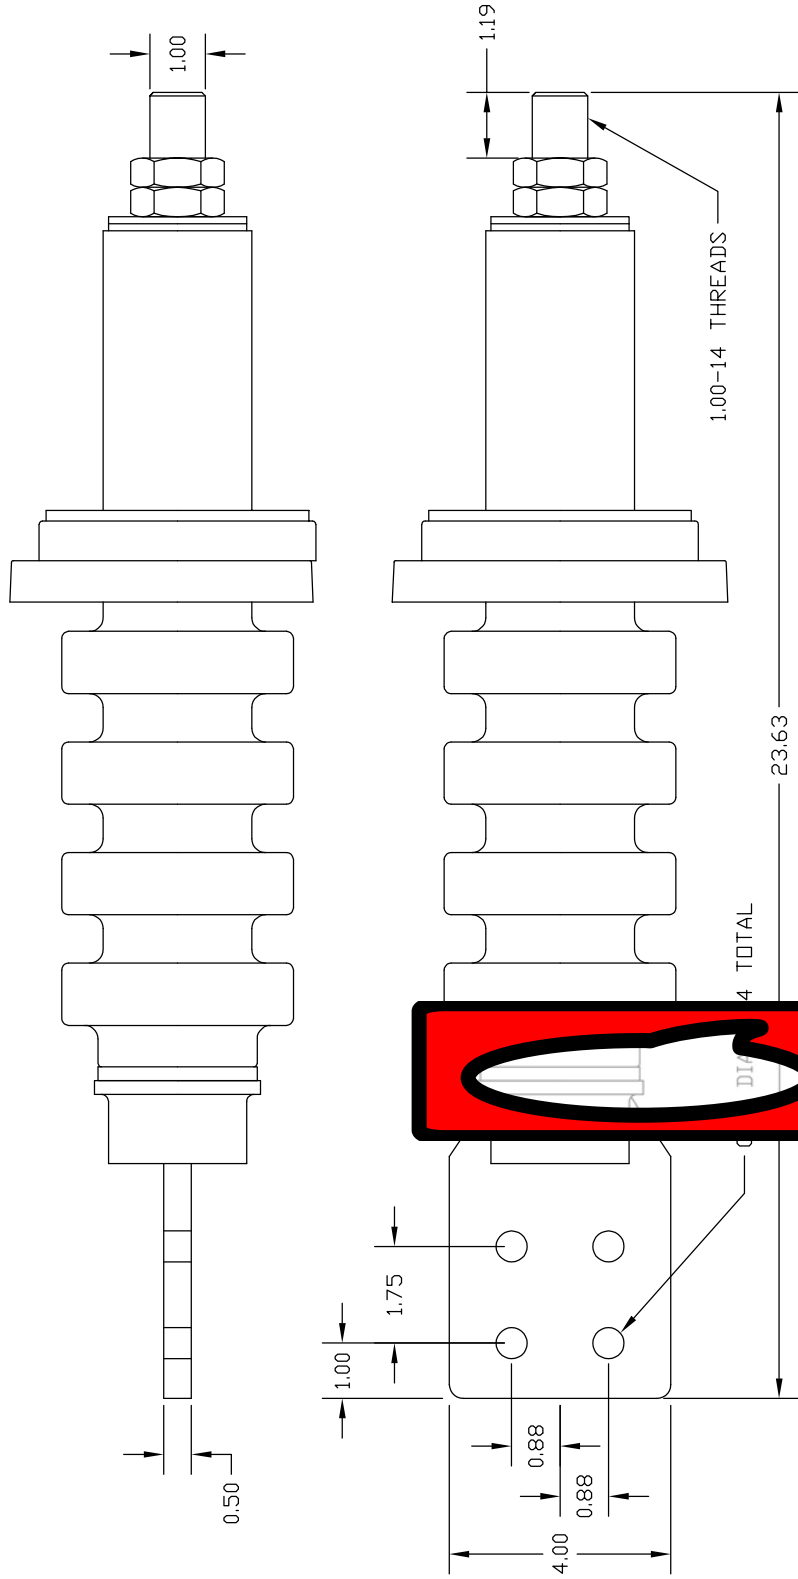

BIL - 110

AMP RATING - 1000

BUSHING MATERIAL - PORCELAIN

LEAD MATERIAL - COPPER

PART NUMBER - 8D12973H01

LV BUSHING
DETAIL NUMBER 23


AS BUILT DRAWINGS
Mar 21, 2016

ABB - South Boston, VA

ABB SOUTH BOSTON, VIRGINIA U.S.A.

DIMENSIONS IN INCHES - NTS

CHANGE

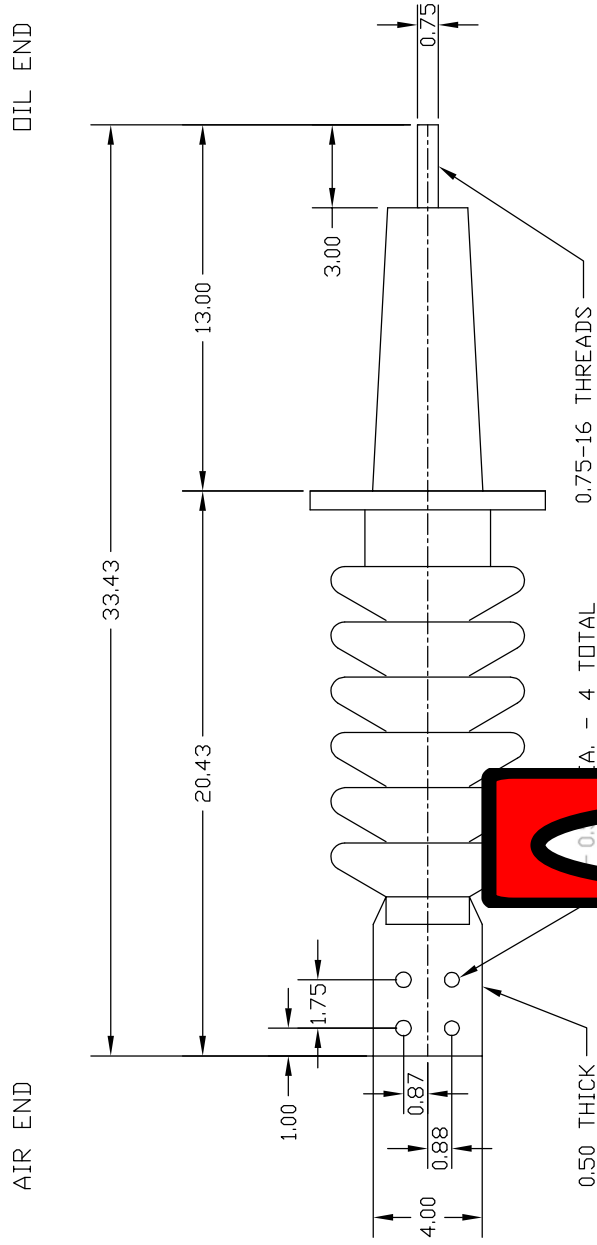

BIL - 200
AMP RATING - 442
BUSHING MATERIAL - PORCELAIN
LEAD MATERIAL - COPPER
PART NUMBER - 8D12245H01

SHOP ORDER BS00132
HV BUSHING
DETAIL NUMBER 24

AS BUILT DRAWINGS
Mar 21, 2016
ABB - South Boston, VA

ABB
SOUTH BOSTON, VIRGINIA U.S.A.

DIMENSIONS IN INCHES - NTS

WIEGMANN CONTROL CABINET - STAINLESS STEEL RATED NEMA 4X

42.00" H X 48.00" W X 20.00" D

LEFT HAND FRONT PANEL

RIGHT HAND FRONT PANEL

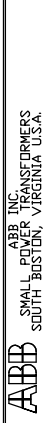
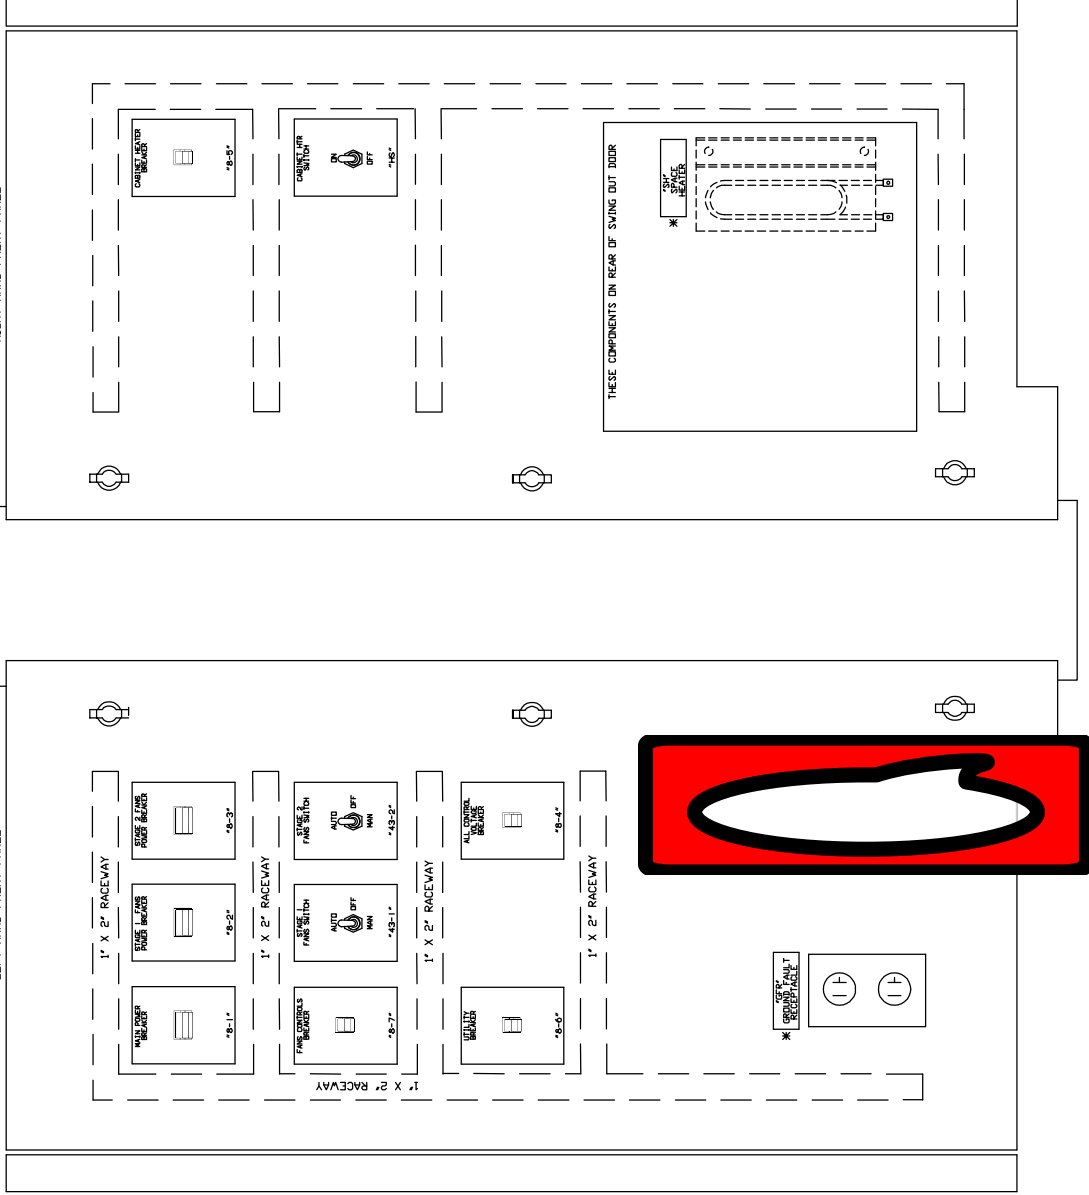


ABB INC.
SMALL POWER TRANSFORMERS
SOUTH BOSTON, VIRGINIA U.S.A.

NOTE: THIS WIRING DIAGRAM MUST NOT BE USED TO DETERMINE THE EXACT LOCATION OF APPARATUS. WIRES OF COLOR TO ALL APPARATUS IS SHOWN IN CONNECTION WITH THE WIRING DIAGRAM. ALL ALARM CONNECTIONS SHOWN IN NORMAL OPERATING POSITION. THE MATERIAL SUPPLIED BY ABB INC. IS ACCORDING TO THE CONTRACT AND IS NOT MODIFIED BY ANYTHING SHOWN ON THIS DIAGRAM.

STAY PUT SWITCH CONTACT
SPRING RETURN
NORMALLY OPEN
NORMALLY CLOSED
RELAY CONTACT
CAPACITOR
CIRCUIT BREAKER
THERMAL ELEMENT

OPERATING COIL
DISCONNECT DEVICE
OPERATING COIL
CAPACITOR
CIRCUIT BREAKER
THERMAL ELEMENT

GROUND BAR

260

710

49T

63

63X

115

T1

3H

115

115

AS BUILT DRAWINGS
Mar 21, 2016
ABB - South Boston, VA

ABB INC.
TRANSFORMER
WIRING DIAGRAM

CHARTS OF THE WIRE CONNECTIONS FOR THE PHYSICAL LAYOUT OF THE PANEL COMPARTMENT ARE SHOWN EITHER ADJACENT THESE AREAS OR IN THE LISTED AT THE RIGHT OF THIS EXPLANATION. WIRE CODE NOS. CORRESPOND TO THOSE SHOWN IN THE WIRING DIAGRAM. "X" INDICATES UNUSED TERMINAL.

CUSTOMER ID

EXPLANATION

SCHEMATIC

TERMINAL

SHALL POWER TRANSFORMER


DRAWING NUMBER
BS00132W1



NOT BE USED TO DETERMINE THE EXACT
WIRES OR CABLES. ALL APPARATUS IS SHOWN IN
ALL ALARM CONTACTS SHOWN IN NORMAL OPERATING

	OPERATING COIL
	DISCONNECT DEVICE
	OPERATING COIL
	CAPACITOR
	CIRCUIT BREAKER
	THERMAL ELEMENT

AS BUILT DRAWINGS
Mar 21, 2016
ABB - South Boston, VA

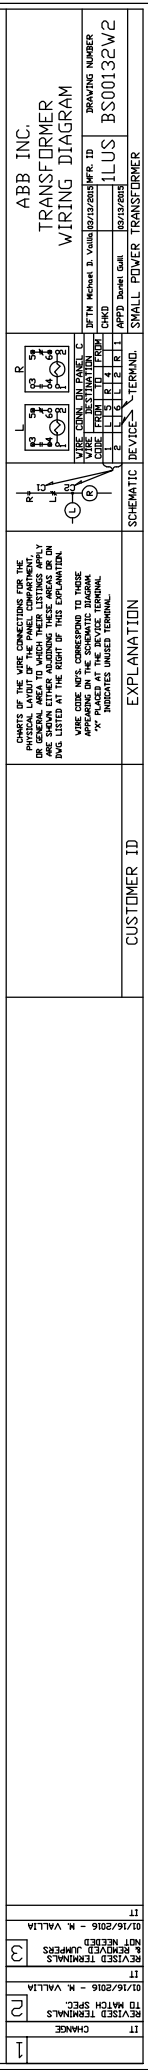

WIRE	FROM	TO	DESTINATION	WIRE
V1	2500	RED	1	14
V2	2500	RED	3	14
V3	2500	RED	4	14
V4	2500	RED	5	14
V291	2500	RED	292	14
V292	2500</			



AS BUILT DRAWINGS

Mar 21, 2016

ABB - South Boston, VA


ABB INC.
SMALL POWER TRANSFORMERS
SOUTH BOSTON, VIRGINIA U.S.A.

NOTE: THIS WIRING DIAGRAM MUST NOT BE USED TO DETERMINE THE EXACT LOCATION OF "APPARATUS" WIRES OR CABLES. ALL APPARATUS IS SHOWN IN NORMAL OPERATING POSITION. ALL ALARM CONTACTS SHOWN IN NORMAL OPERATING CONDITION.


THE MATERIAL SUPPLIED BY ABB INC. IS ACCORDING TO CONTRACT AND IS NOT MODIFIED BY ANYTHING SHOWN ON THIS DIAGRAM.

STAY PUT
SPRING RETURN
NORMALLY OPEN
NORMALLY CLOSED

SWITCH CONTACT
DISCONNECT DEVICE
OPERATING COIL
RELAY CONTACT
CAPACITOR
CIRCUIT BREAKER
THERMAL ELEMENT

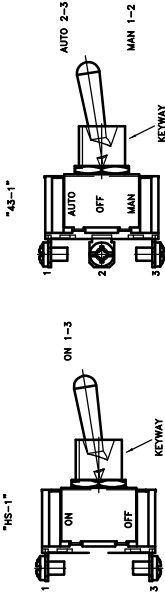

VIEW OF '43-1' AND 'HS-1' SWITCHES
(SWITCHES MOUNTED SO KEYWAY IS DOWN)

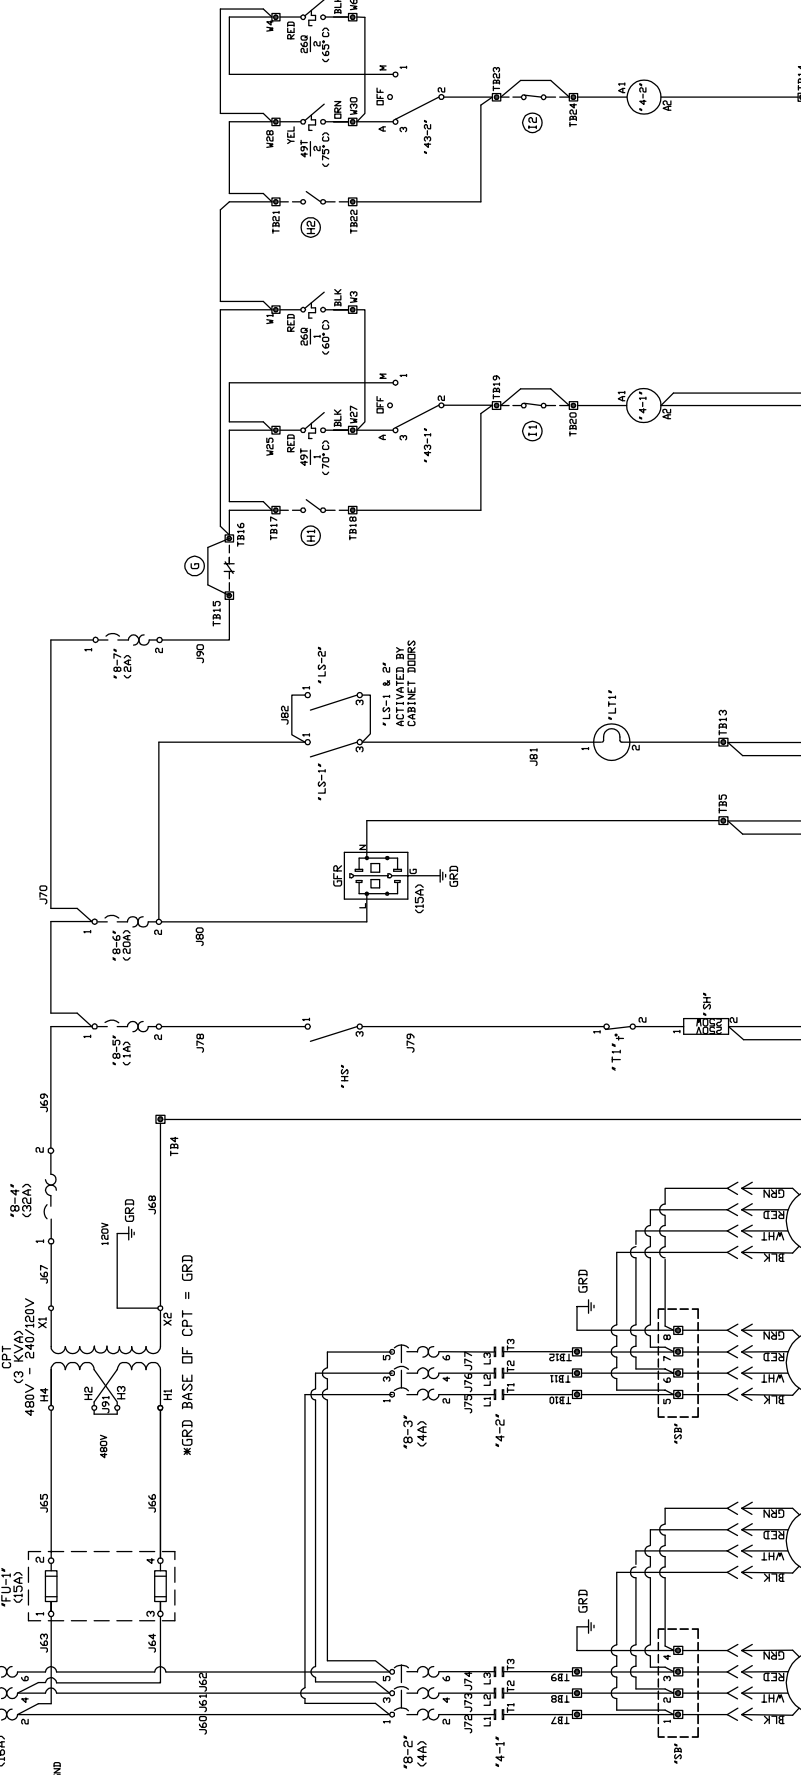




SMALL POWER TRANSFORMERS

SOUTH BOSTON, VA.




VOLTS		THREE PHASE		FULL LOAD KVA				
HV	34500Y/19920	NATURAL ESTER FLUID INSULATED		12000	KNAN			
LV	13800	UNIT SUBSTATION TRANSFORMER		16000	KNAF			
60 HERTZ		CLASS KNAN/KNAF/KNAF INSULATED INSULATION		20000	KNAF			
				65	°C RISE			
				GALLONS LIQUID	2505			
INSTRUCTION BOOK	PC-1002	MFR ID	1LUS	SERIAL	BS00132 -####			
		MANUFACTURE DATE		##/##				
FULL WAVE IMPULSE TEST LEVEL: H.V. 150 KV., L.V. 95 KV.								
IMPEDANCE IMP_VAL1 % AT 12000 KVA 34500 TO 13800 VOLTS.								
APPROX. WEIGHT IN LBS. CORE AND COILS		31737	CASE	15455	LIQUID	19037	TOTAL	66229
MADE IN U.S.A.		ABB INC.				1LUSBS00132N1		

YND1

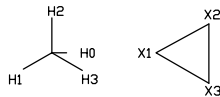

CONNECTIONS					
WINDING	VOLTS	20000 KVA AMPERES	POS.	TAP CHANGER	
				CONNECTS	
HIGH VOLTAGE WYE COPPER	37950	304.2	1	5	TO 6
	37090	311.3	2	4	TO 6
	36230	318.7	3	4	TO 7
	35360	326.5	4	3	TO 7
	34500	334.7	5	3	TO 8
	33640	343.3	6	2	TO 8
	32780	352.3	7	2	TO 9
LOW VOLTAGE DELTA COPPER	13800	836.8			

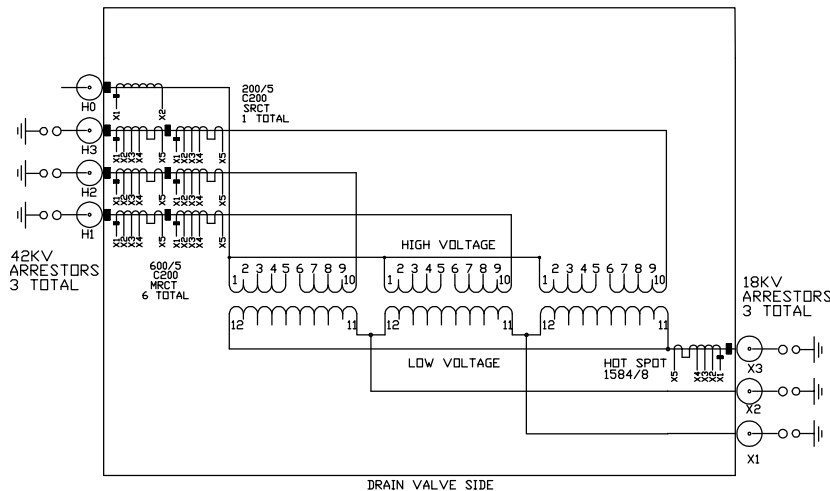

DRAIN VALVE SIDE

THE OPERATING PRESSURE IS LIMITED BY THE SEALED-AIR FLUID PRESERVATION SYSTEM, UNLESS REMOVED TO 6.5 LBS. PER SQUARE INCH POSITIVE AND 6.5 LBS. PER SQUARE INCH NEGATIVE. THE TRANSFORMER TANK IS DESIGNED TO WITHSTAND A POSITIVE OR NEGATIVE PRESSURE OF 15 LBS. PER SQUARE INCH. THE 25°C LIQUID LEVEL IS 11.11 INCHES BELOW HIGHEST MANHOLE FLANGE. LIQUID LEVEL CHANGES .57 INCH FOR EACH 10°C CHANGE IN AVERAGE LIQUID TEMPERATURE. THE TRANSFORMER MUST NOT BE ENERGIZED FROM ANY VOLTAGE SOURCE WHEN TAP CHANGER IS OPERATED. SUITABLE FOR OPERATION AT OR BELOW 3300 FEET ALTITUDE AT NAMEPLATE RATING. AT THE TIME OF SHIPMENT THIS UNIT CONTAINED LESS THAN 1 PPM OF PCBS.

MFR. ID	SHOP ORDER
1LUS	BS00132
MFR. ID	DRAWING #
1LUS	BS00132N1

5/16 INCH HOLES FOR 190-32 X 3/16 SCREW
SIZE 6.25 INCHES X 10.0 INCHES AREA 62.5 SQUARE INCHES
DISTANCE BETWEEN CENTERS OF HOLES ON LONG EDGE 9 1/32 INCH ± 1/64 ON SHORT EDGE 5 27/32 INCH ± 1/64

1		2	ADDED TAP RANGE TO +4, -2 & 2.5% UPDATED LV ARRESTER TO 42 KV				
N.P.DRAFT. DRAFT. ENGINEER	DATE	N.P.DRAFT. DRAFT. ENGINEER	DATE	N.P.DRAFT. DRAFT. ENGINEER	DATE	N.P.DRAFT. DRAFT. ENGINEER	DATE
D.Gull	01/07/15	D.Gull	04/27/15				

